


MUSEUM CAMPUS - NEW EXTERIOR SIGNAGE

Key #	Graphic #	Graphic Name
A	-	Existing Museum Title Sign
B	MC.0.1.G.01	Museum Campus Introduction
C	MC.0.2.G.01	Minor Campus Intro (North Entry)
D	MC.0.3.G.01	Minor Campus Intro (SE Entry)
1	GC.0.1.G.01/WT.G.01	#1 - Guest Cottage Introduction
2	WT.G.02	#2 - Rose Garden
3	WT.G.03	#3 - Romero Cabin (Minor)
4	WT.G.04	#4 - Firehouse ID (Minor)
5	WT.G.05	#5 - Big House
5	WT.G.06	#6 - Ancestral Pueblo
6	WT.G.07	#7 - Bathtub Row
7	BH.0.1.G.01/WT.G.08	#8 - Bethe House Intro
8	WT.G.09	#9 - Performing Arts Center
9	WT.G.10	#10 - Bradbury Science Center
10	WT.G.11	#11 - Post Office
11	WT.G.12	#12 - Fuller Lodge
12	WT.G.13	#13 - Ashley Pond
13	WT.G.14	#14 - Touch the Sky
14	WT.G.15	#15 - Power House
15	WT.G.16	#16 - Chimney Stack (Minor)
16	BH.6.1.G.01	A Sense of Place - Section Message

Note: Refer to Site photos for exact placement

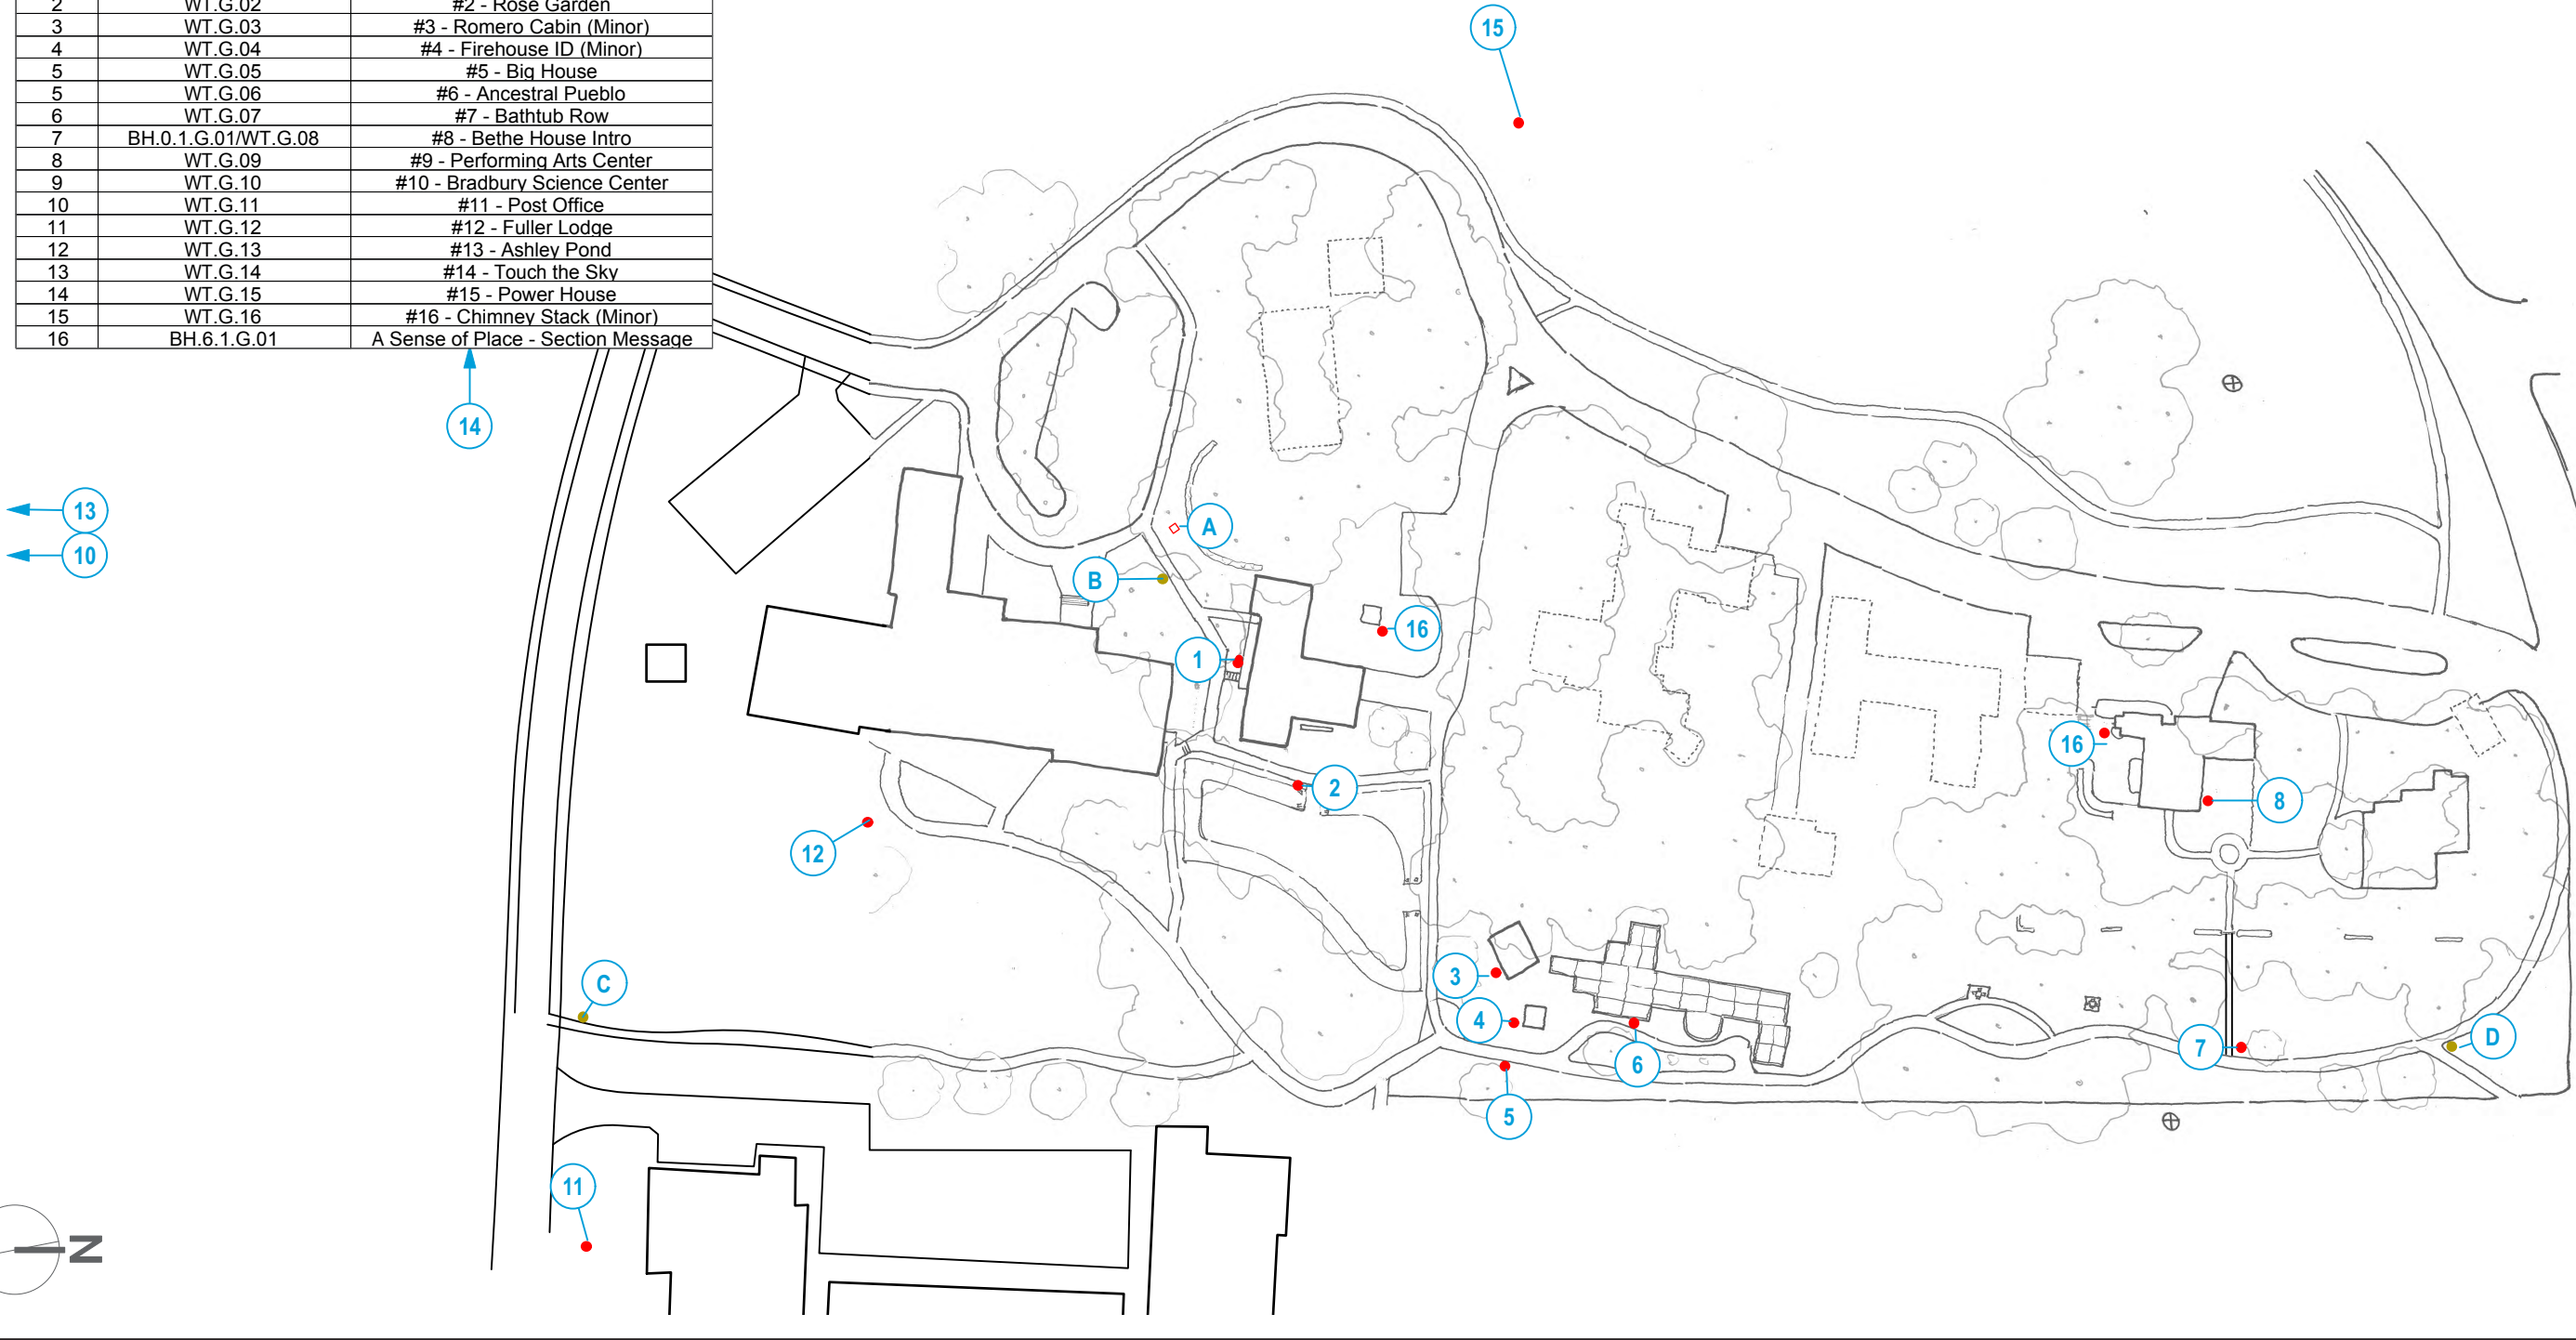

LOS ALAMOS  
HISTORY MUSEUM  
1050 Bathtub Row  
Los Alamos, NM 87544

PROJECT TITLE  
LAHM

SHEET TITLE  
Museum Campus - New Signage

ISSUED FOR  
Pre-Production Prep

Approval of the information presented indicates that the LAHM is directing Quatrefoil to proceed. In the case of "Approved as Noted", notes must also be clearly written and provide specific direction. Additional comment pages can be attached but these must contain a direct reference to this page. Information that is not approved must be specifically identified as "Not Approved", otherwise the information shall be considered approved. Note that changes requested by the LAHM that imply or result in a change to approved work may result in additional charges to the LAHM and schedule delays. **An approval box must be checked and initialed.**

APPROVAL

☐ Approved

☐ Approved as Noted

☐ Not Approved

**Quatrefoil Associates**  
29 C Street, Laurel MD 20707


September 06, 2016

NO.  
MC.X101





MC.0.1.G.01 - Museum Campus Introduction

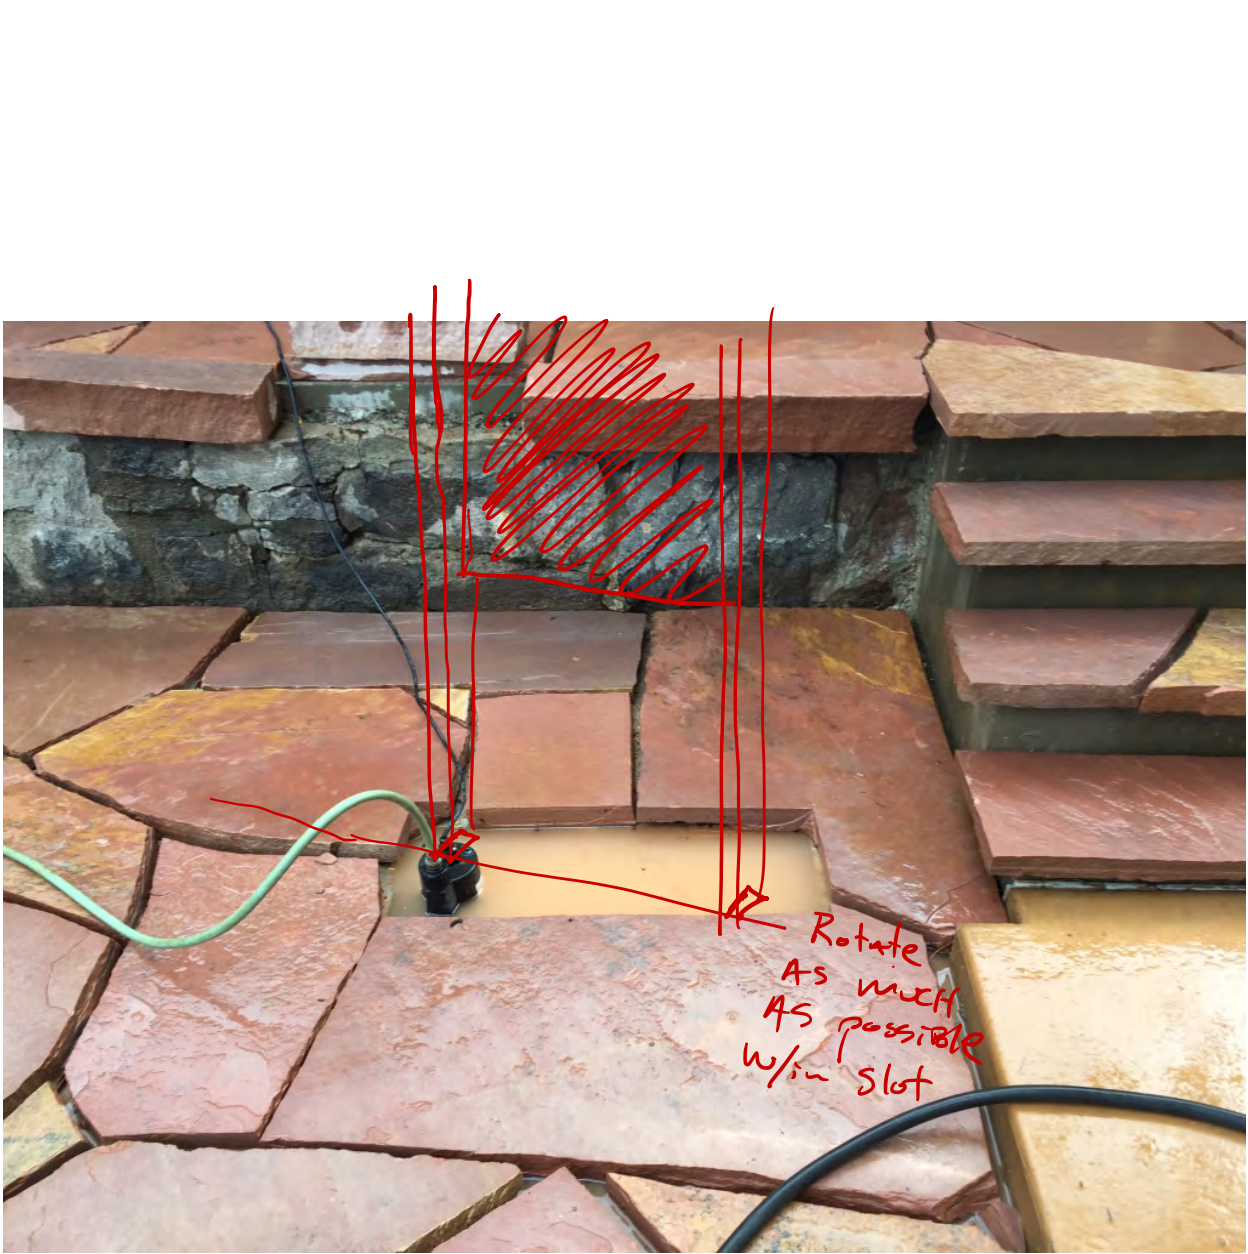

GC.0.1.G.01/WT.G.01 - Guest Cottage Introduction





WT.G.16 - Chimney Stack Minor Walking Tour Sign (Snake Stack Sign Holder)



WT.G.02 - Rose Garden Walking Tour Sign





WT.G.03 - Romero Cabin Minor Walking Tour Sign (Snake Stake Sign Holder)



WT.G.04 - Fire House Minor Walking Tour Sign (Snake Stake Sign Holder)





WT.G.05 - Big House Walking Tour Sign



WT.G.06 - Ancestral Pueblo Walking Tour Sign





WT.G.07 - Bathtub Row Walking Tour Sign



BH.0.1.G.01/WT.G.08 - Bethe House Introduction



LOS ALAMOS  
HISTORY MUSEUM  
1050 Bathtub Row  
Los Alamos, NM 87544

PROJECT TITLE  
LAHM

SHEET TITLE  
Exterior Sign Site Photos

ISSUED FOR  
Pre-Production Prep


 **Quatrefoil Associates**  
29 C Street, Laurel MD 20707

September 06, 2016

NO.  
MC.X405





BH.6.1.G.01 - A Sense of Place Section Message Sign

MC.0.2.G.01 - Minor Campus Map (North Entry)



LOS ALAMOS  
HISTORY MUSEUM  
1050 Bathtub Row  
Los Alamos, NM 87544

PROJECT TITLE  
LAHM

SHEET TITLE  
Exterior Sign Site Photos

ISSUED FOR  
Pre-Production Prep




**Quatrefoil Associates**  
29 C Street, Laurel MD 20707

September 06, 2016

NO.

MC.X406





WT.G.09 - Performing Arts Center Walking Tour Sign



WT.G.15 - Power House Walking Tour Sign





WT.G.14 - Touch the Sky Walking Tour Sign



WT.G.13 - Ashley Pond Walking Tour Sign



LOS ALAMOS  
HISTORY MUSEUM  
1050 Bathtub Row  
Los Alamos, NM 87544

PROJECT TITLE  
LAHM

SHEET TITLE  
Exterior Sign Site Photos

ISSUED FOR  
Pre-Production Prep




**Quatrefoil Associates**  
29 C Street, Laurel MD 20707

September 06, 2016

NO.

MC.X408





WT.G.10 - Ice House Walking Tour Sign



WT.G.11 - Post Office Walking Tour Sign



LOS ALAMOS  
HISTORY MUSEUM  
1050 Bathtub Row  
Los Alamos, NM 87544

PROJECT TITLE  
LAHM

SHEET TITLE  
Exterior Sign Site Photos

ISSUED FOR  
Pre-Production Prep




**Quatrefoil Associates**  
29 C Street, Laurel MD 20707

September 06, 2016

NO.

MC.X409





MC.0.3.G.01 - Minor Campus Introduction - SE Entry



WT.G.12 - Fuller Lodge Walking Tour Sign